1540 E. Northwest Highway

For Lease RETAIL SPACE

PALATINE, IL 60074



- Directly across the street from the 326-acre proposed new home of the Chicago Bears
- \blacktriangleright ±3062 SF free standing fast food restaurant with drive-thru available for lease
- Close proximity to IL-53
- Across the street from Arlington Park Metra station (Union Pacific Northwest line)
- Area tenants include McDonald's, Dunkin', Orbit Skate Center, Soccer City Palatine, and more

DEMOGRAPHIC SUMMARY

	1 Mile	3 Miles	5 Miles
Estimated Population	11,233	130,858	288,050
Daytime Population	11,507	139,968	336,702
Estimated Households	4,640	52,256	115,052
Estimated Average Household Income	\$109,584	\$114,435	\$110,774

DOUG RENNER

doug.renner@baumrealty.com 312.275.3137

MARK FREDERICKS

mark@baumrealty.com 312.275.3109




© 2022 All information supplied is from sources deemed reliable and is furnished subject to errors, omissions, modifications, removal of the listing from sale or lease, and to any listing conditions, including the rates and manner of payment of commissions for particular offerings, the terms of which are available to principals or duly licensed brokers. Any square footage dimensions set forth are approximate.

BAUM REALTY GROUP, LLC - 1030 W. CHICAGO AVENUE, SUITE 200 - CHICAGO, IL 60642 - 312.666.3000 - WWW.BAUMREALTY.COM

1540 E. Northwest Highway

PALATINE, IL 60074

For Lease RETAIL SPACE

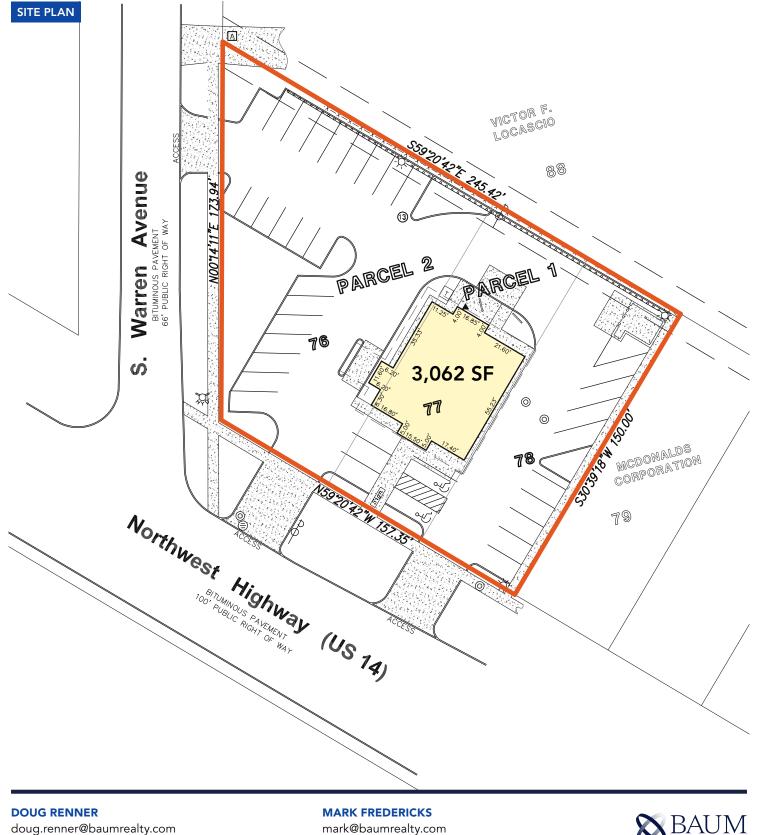

312.275.3137

mark@baumrealty.com 312.275.3109




© 2022 All information supplied is from sources deemed reliable and is furnished subject to errors, omissions, modifications, removal of the listing from sale or lease, and to any listing conditions, including the rates and manner of payment of commissions for particular offerings, the terms of which are available to principals or duly licensed brokers. Any square footage dimensions set forth are approximate

BAUM REALTY GROUP, LLC · 1030 W. CHICAGO AVENUE, SUITE 200 · CHICAGO, IL 60642 · 312.666.3000 · WWW.BAUMREALTY.COM

1540 E. Northwest Highway

PALATINE, IL 60074

AS BUILT PLAN

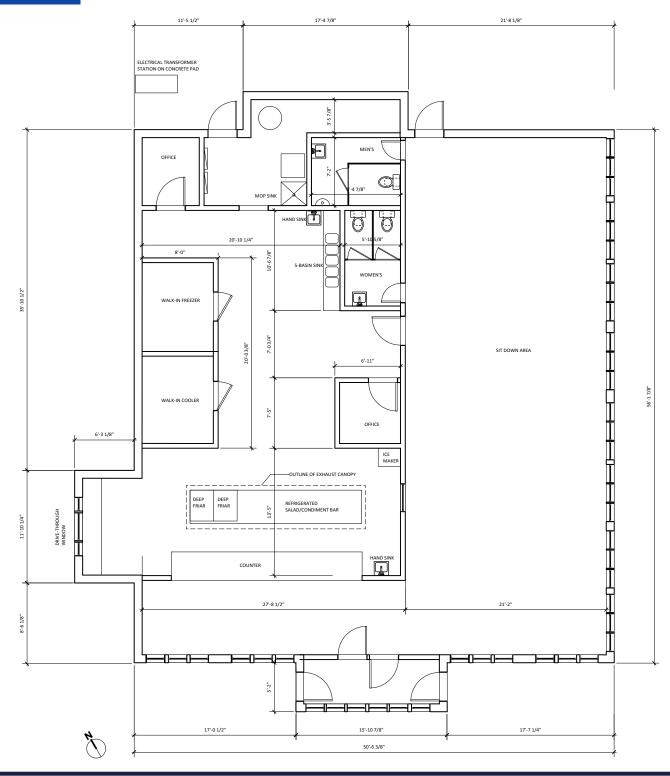

DOUG RENNER doug.renner@baumrealty.com 312.275.3137

MARK FREDERICKS

mark@baumrealty.com 312.275.3109



© 2022 All information supplied is from sources deemed reliable and is furnished subject to errors, omissions, modifications, removal of the listing from sale or lease, and to any listing conditions, including the rates and manner of payment of commissions for particular offerings, the terms of which are available to principals or duly licensed brokers. Any square footage dimensions set forth are approximate.





This map was produced using data from private and government sources deemed reliable. The information herein is provided without representation or warranty. Copyright © 2022 Baum Realty Group, LLC. All rights reserved. www.baumrealty.com.

